


1 1ST FLOOR PLAN  
SCALE 1/4" = 1'-0"

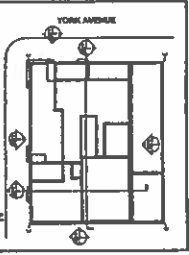

KEY PLAN  
This plan is intended to show the location of the building on the street grid. It is not a site plan and does not show the building's footprint or other details.

Δ 042713	DOOR FRAME
Δ 042714	VALVE ENGINEERING REVISION 01
114712	POW CONSTRUCTION
Δ 1142715	APPROXIM 01
Δ 042715	DOOR P.A.A.
Δ 042712	REV 2 DOOR REVISION
Δ 042713	REV 1 DOOR REVISION
042709	DOOR FRAME SET
042711	DOOR SET

The Stephen B. Jacobs Group, P.C.  
Architects and Planners  
110 Park Avenue South  
New York, N.Y. 10011  
212-413-1111

Andi Popper Interior Design  
Interior Designer  
111 Park Avenue South  
New York, N.Y. 10011  
212-413-1111


W.S.P. Cantor Seink  
Structural Engineer (Professional Registered)  
200 East 74th Street  
New York, N.Y. 10017  
212-487-1888

Sideris Kerkiras Engineers  
Civil/Structural Engineer (Professional Registered)  
217-21 West 11th Street  
New York, N.Y. 10011  
212-487-1888

501 EAST 74TH STREET  
New York, N.Y. 10011


1ST FLOOR PLAN

REGISTERED ARCHITECT  
STEPHEN B. JACOBS  
NEW YORK STATE  
A-1110.04  
DATE: 11/11/11  
SCALE: 1/4" = 1'-0"


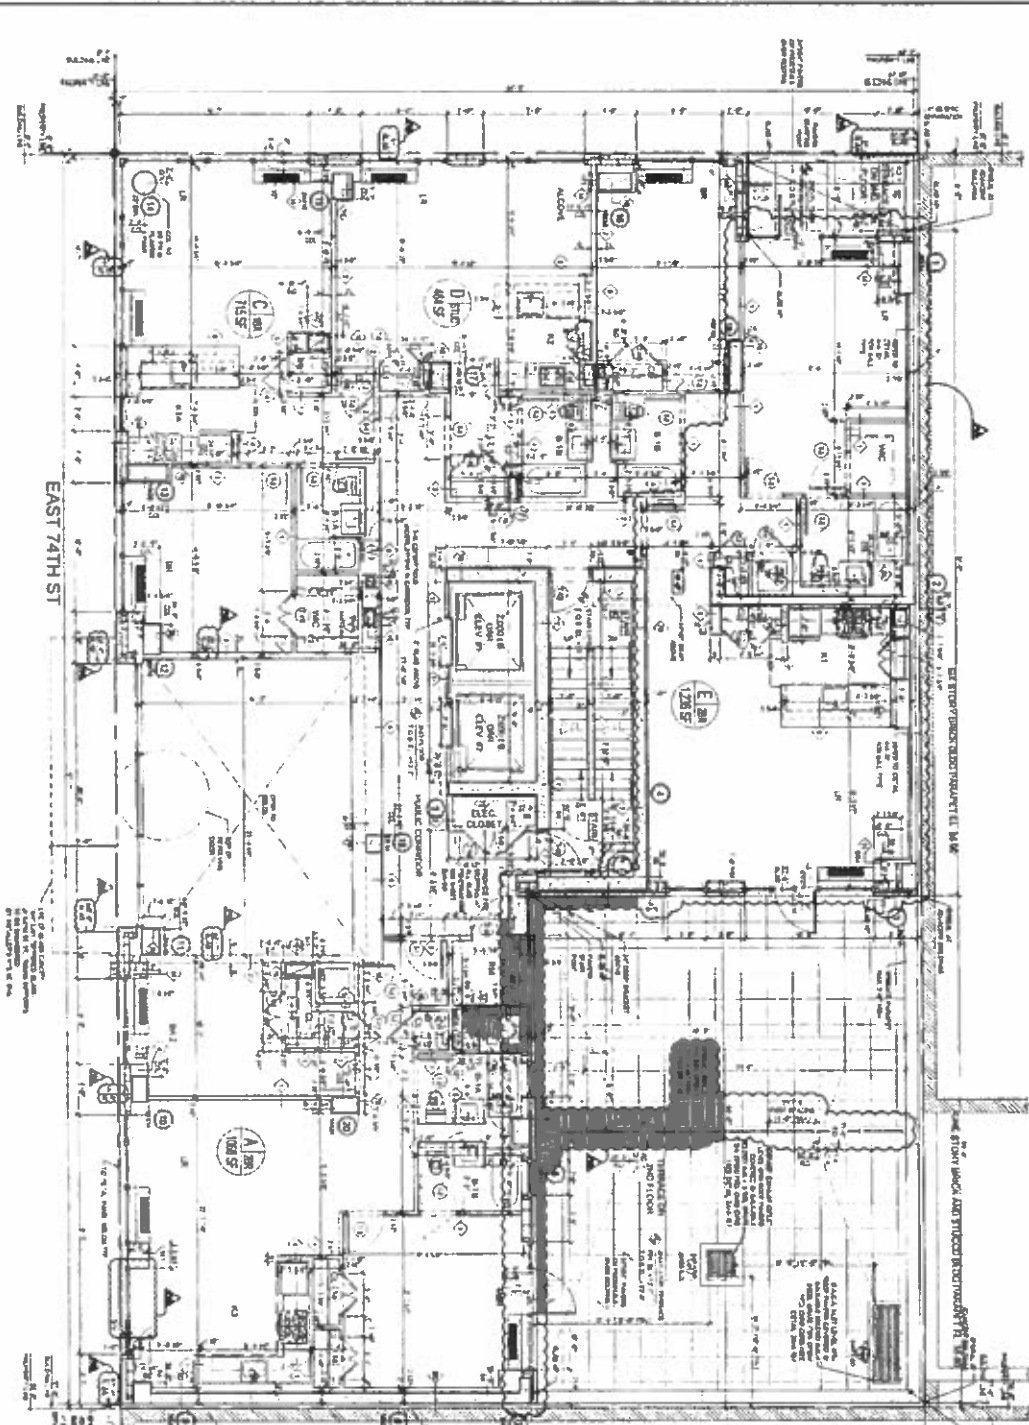


**2** 2ND FLOOR PLAN  
SCALE 1/4" = 1'-0"

**2A** EXHAUST OUTLET  
SCALE 3/4" = 1'-0"

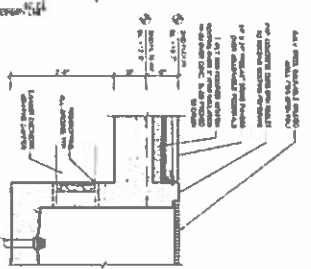

**2B** OUTSIDE AIR INLET  
SCALE 3/4" = 1'-0"

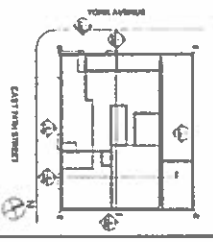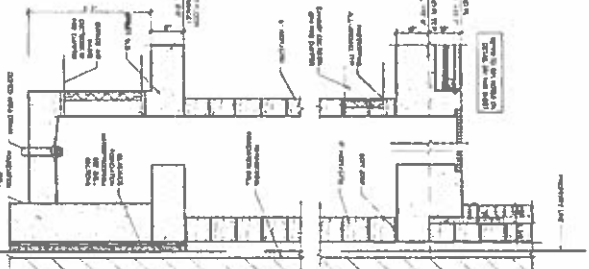

**KEY PLAN**

DOOR 115 DOOR FRAME

071614 VALVE EXHAUSTING REVISION 61A

042714 VALVE PROPORTIONING REVISION 11

141612 FURN CONSTRUCTION

102215 AIR CONDITIONING

042615 DOOR FRAME

042615 DOOR SET

**The Stephen B. Jacobs Group, P.C.**  
Architects and Planners  
481 Park Avenue South  
New York, N.Y. 10013  
212-411-1111


**Audi Pepper Interior Design**  
Interior Designers  
881 Park Avenue South  
New York, N.Y. 10013  
212-411-7112

**W.S.P. Cantor Schick**  
Consulting Engineers (Mechanical Engineering)  
200 West 42nd Street  
New York, N.Y. 10018  
212-411-4444

**Sidaris Kofaris Engineers**  
Civil and Mechanical Engineers  
212 West 42nd Street  
New York, N.Y. 10018  
212-411-1111



**501 EAST 74TH STREET**  
New York, N.Y. 10018

2ND FLOOR PLAN

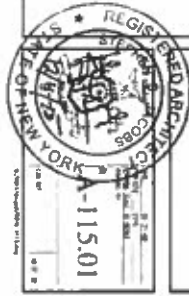


YORK AVENUE


2) 7TH - 8TH FLOOR PARTIAL PLAN  
SCALE 1/4" = 1'-0"

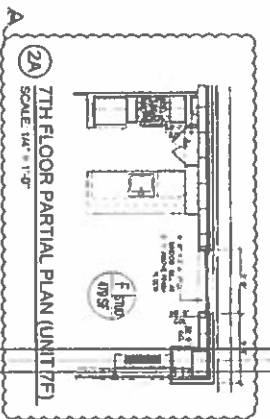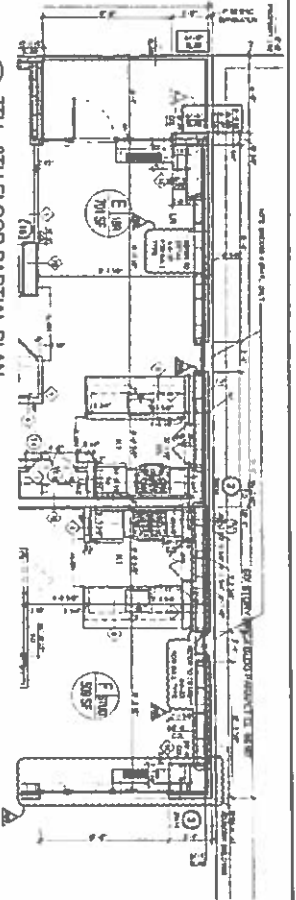

1) 3RD - 8TH FLOOR PLAN  
SCALE 1/4" = 1'-0"

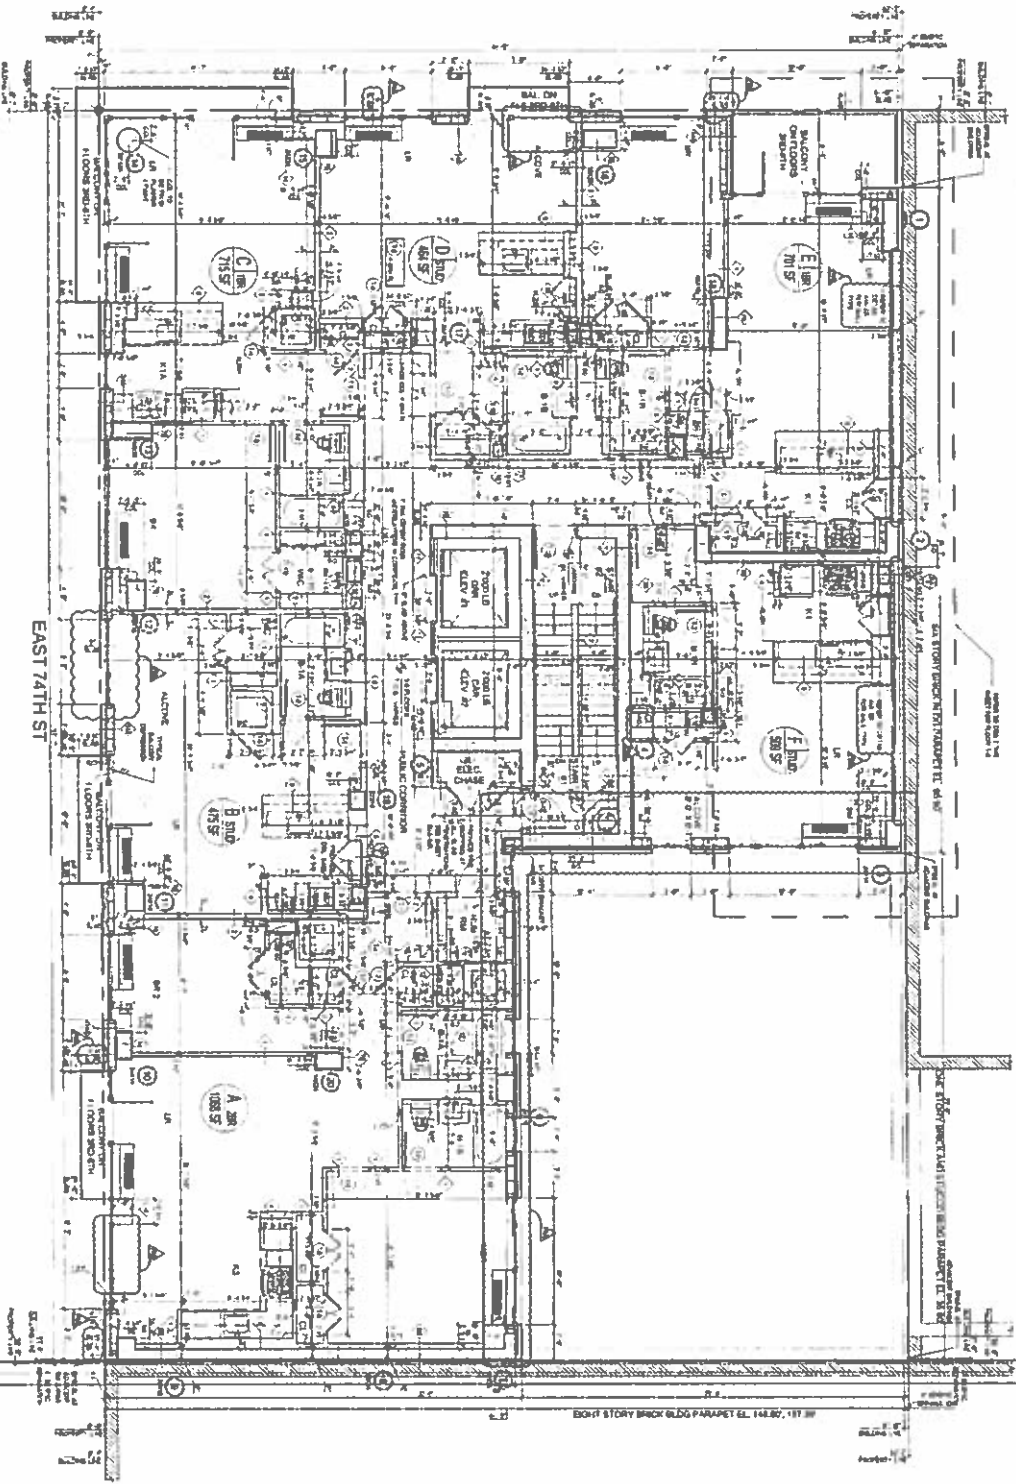

DATE	DESCRIPTION
12/10/03	ISSUED FOR PERMIT
12/10/03	ISSUED FOR CONSTRUCTION
12/10/03	ISSUED FOR RECORD

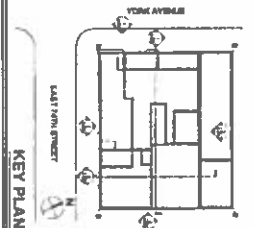

021210	0000 PLAN
021214	VALUE DETERMINING
021214	REVISION 10A
021214	VALUE SCHEDULED
110013	1 OF CONSTRUCTION
102725	ASB SCHEDULE
021212	0000 PLAN
021111	REV 2008 REVISION
021208	DOOR FRAME SET
021208	DOOR SET

**The Stephen B. Jacobs Group, P.C.**  
 Architects and Planners  
 201 West Avenue South  
 New York, N.Y. 10018  
 Tel: 212.261.1112  
 Fax: 212.261.1113


**Avril Reppe Interior Design**  
 161 West Avenue South  
 New York, N.Y. 10018  
 Tel: 212.261.1112  
 Fax: 212.261.1113



**W.S.P. Center Schink**  
 Consulting Engineers (Civil and Mechanical)  
 201 West Avenue South  
 New York, N.Y. 10018  
 Tel: 212.261.1112  
 Fax: 212.261.1113

**Siders Kellas Engineers**  
 Consulting Engineers (Civil & Mechanical)  
 211 22 West 42nd Street  
 New York, N.Y. 10018  
 Tel: 212.261.1112  
 Fax: 212.261.1113

501 EAST 74TH STREET  
 NEW YORK, N.Y. 10018

3RD - 8TH FLOOR PLAN

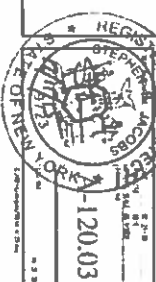

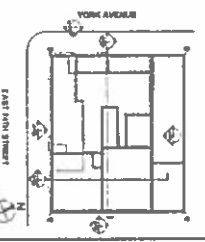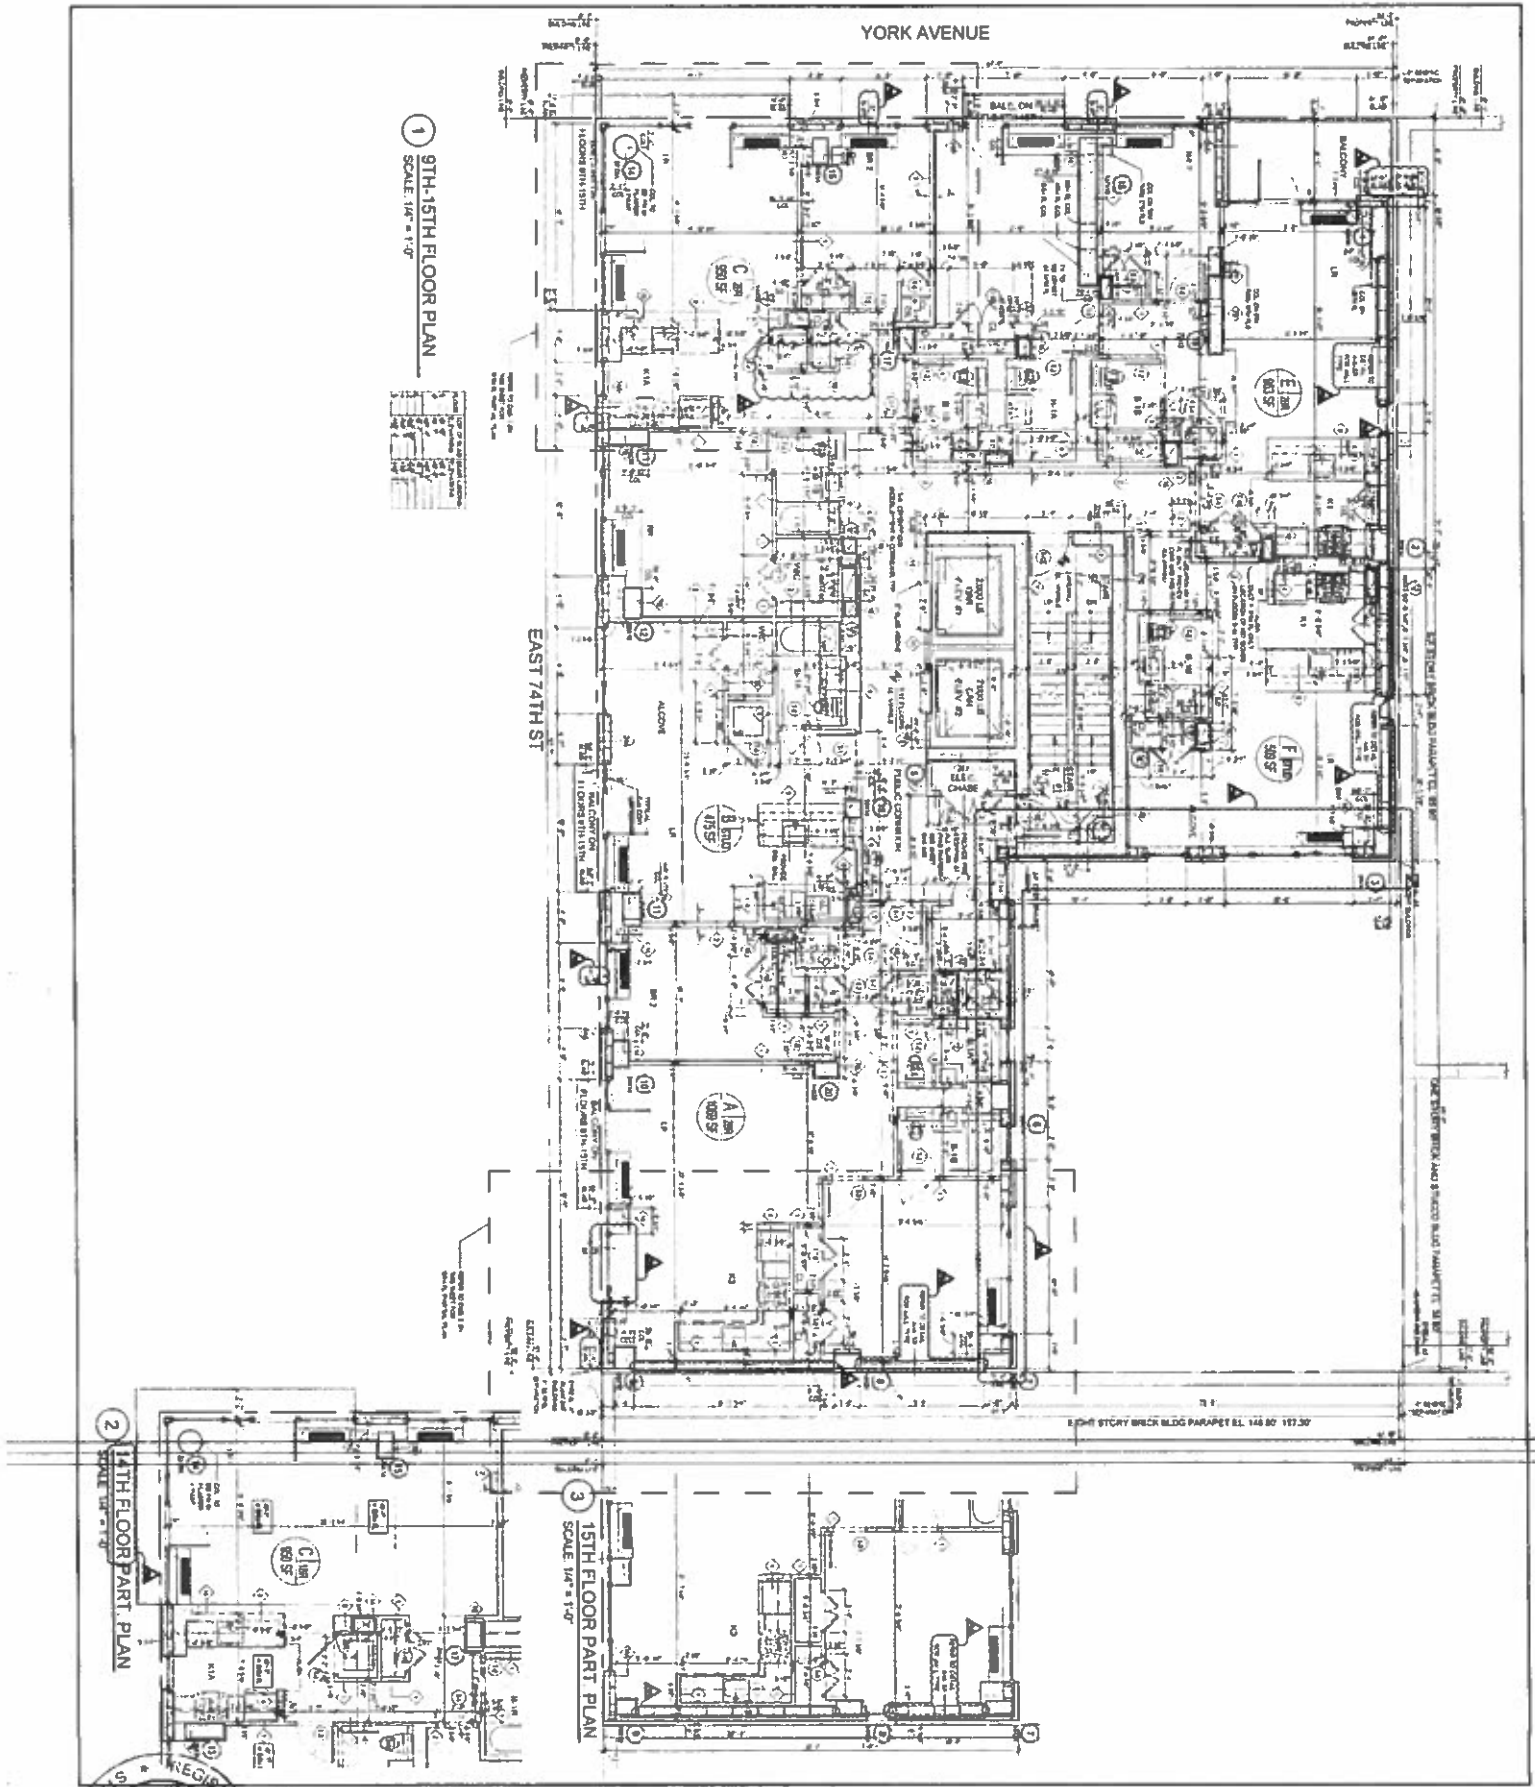

**KEY PLAN**  
 YORK AVENUE  
 EAST 74TH STREET

DATE: 12/15/10	DOCS: P.A.A.B.
DESIGNER: VALUE ENGINEERING CONSULTANTS	
OWNER: VALUE ENGINEERING CONSULTANTS	
PROJECT: 14th FLOOR PART PLAN	
DATE: 12/15/10	DOCS: P.A.A.B.
PROJECT: 15th FLOOR PART PLAN	
DATE: 12/15/10	DOCS: P.A.A.B.
PROJECT: 9th-15th FLOOR PLAN	

**The Stephen B. Jacobs Group, P.C.**  
 Architects and Planners  
 717 Park Avenue South  
 New York, NY 10018  
 Phone: 212 755 1111

**Avail Pepper Interior Design**  
 Interior Designers  
 111 Park Avenue South  
 New York, NY 10018  
 Phone: 212 755 1111

**W.S.P. Cantor Schenk**  
 Consulting Engineers (Structural Engineering)  
 111 Park Avenue South  
 New York, NY 10018  
 Phone: 212 755 1111


**Sidaris Kefalas Engineers**  
 Consulting Engineers (Mechanical Engineering)  
 111 Park Avenue South  
 New York, NY 10018  
 Phone: 212 755 1111

**501 EAST 74TH STREET**  
 New York, NY 10018

**9TH-15TH FLOOR CONST. PLAN**  
 14TH FLOOR PART PLAN (ENC. 3) (14th)




130.02

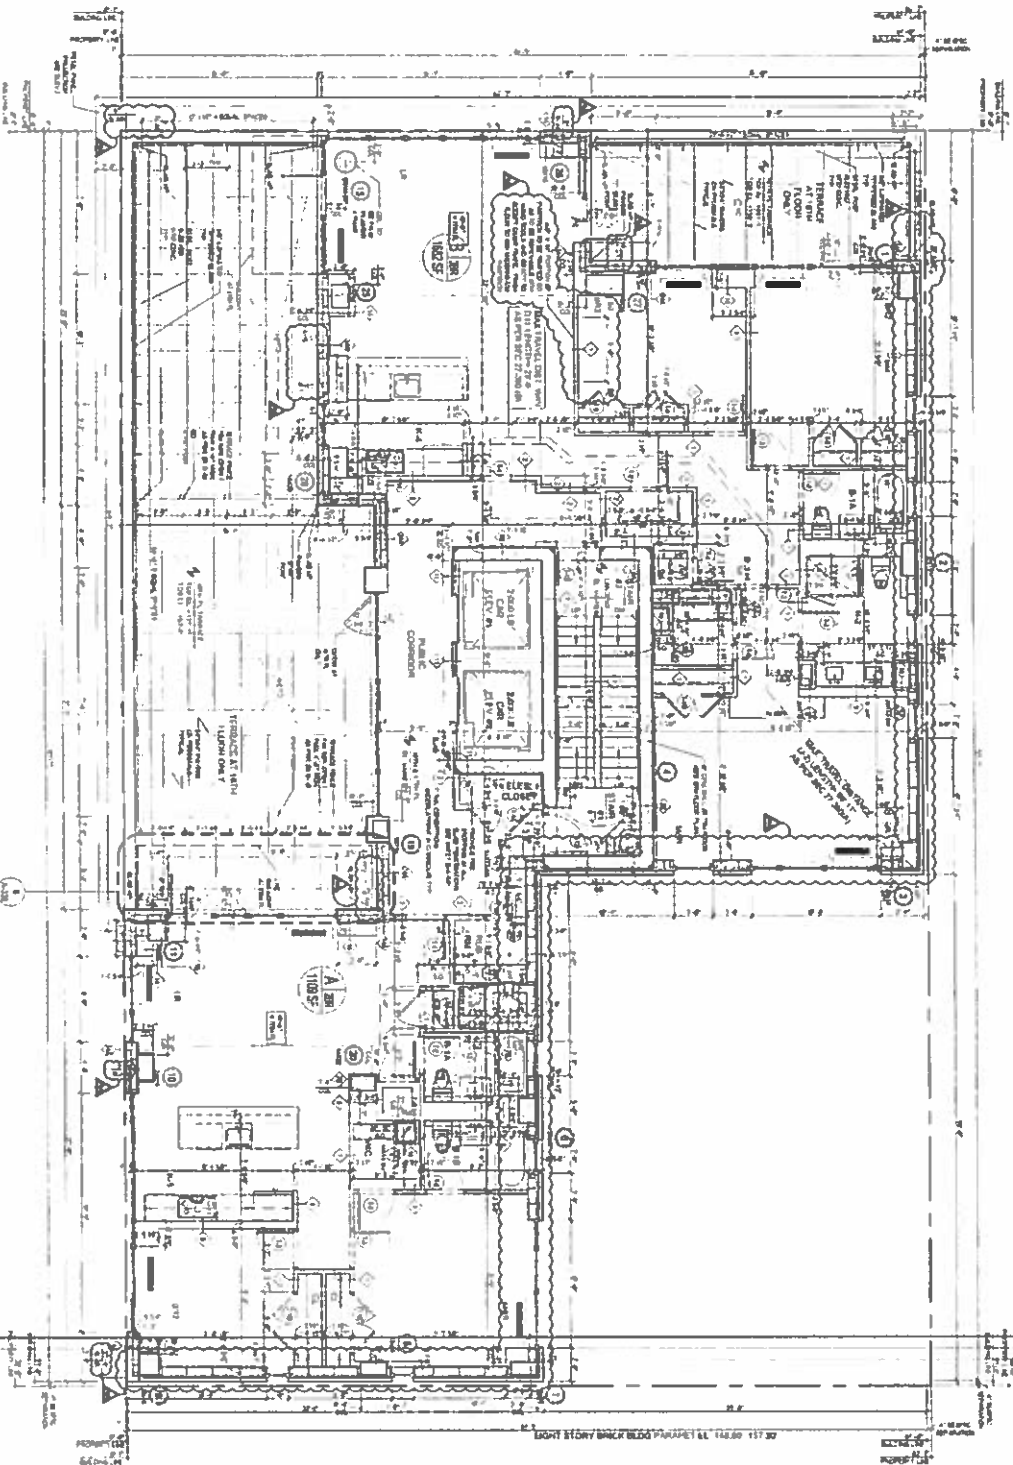

1 16TH-17TH FLOOR PLAN  
SCALE 1/4" = 1'-0"

16TH-17TH FLOOR PLAN	DATE: 08/14/13
16TH-17TH FLOOR PLAN	DATE: 08/14/13
16TH-17TH FLOOR PLAN	DATE: 08/14/13

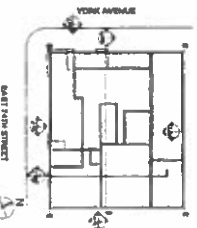

**KEY PLAN**  
 16TH-17TH FLOOR PLAN  
 501 EAST 24TH STREET  
 NEW YORK, NY 10018

01	0101	0101	0101	0101	0101
02	0201	0201	0201	0201	0201
03	0301	0301	0301	0301	0301
04	0401	0401	0401	0401	0401
05	0501	0501	0501	0501	0501
06	0601	0601	0601	0601	0601
07	0701	0701	0701	0701	0701
08	0801	0801	0801	0801	0801
09	0901	0901	0901	0901	0901
10	1001	1001	1001	1001	1001
11	1101	1101	1101	1101	1101
12	1201	1201	1201	1201	1201
13	1301	1301	1301	1301	1301
14	1401	1401	1401	1401	1401
15	1501	1501	1501	1501	1501
16	1601	1601	1601	1601	1601

**The Stephen B. Jacobs Group, P.C.**  
 Architects and Planners  
 3175 Avenue of the Stars  
 New York, N.Y. 10018  
 Tel: 212-317-1111  
 Fax: 212-317-1112

**Archi Reppert Interior Design**  
 2817 York Avenue  
 New York, N.Y. 10018  
 Tel: 212-475-7712


**W.S.P. Cantor Scaulk**  
 Consulting Engineers / Structural Engineering  
 272 East 40th Street  
 New York, N.Y. 10018  
 Tel: 212-677-0000

**Silvert's Keldas Engineers**  
 Consulting Engineers (MEP) / Mechanical  
 117-22 Queens Boulevard  
 Rego, N.Y. 11380  
 Tel: 718-491-1001


**501 EAST 24TH STREET**  
 New York, N.Y. 10018

16TH-17TH FLOOR CONST PLAN  
 16TH-17TH FLOOR MKT PLAN

**REGISTERED PROFESSIONAL ENGINEER**  
 STATE OF NEW YORK  
 No. 140.03

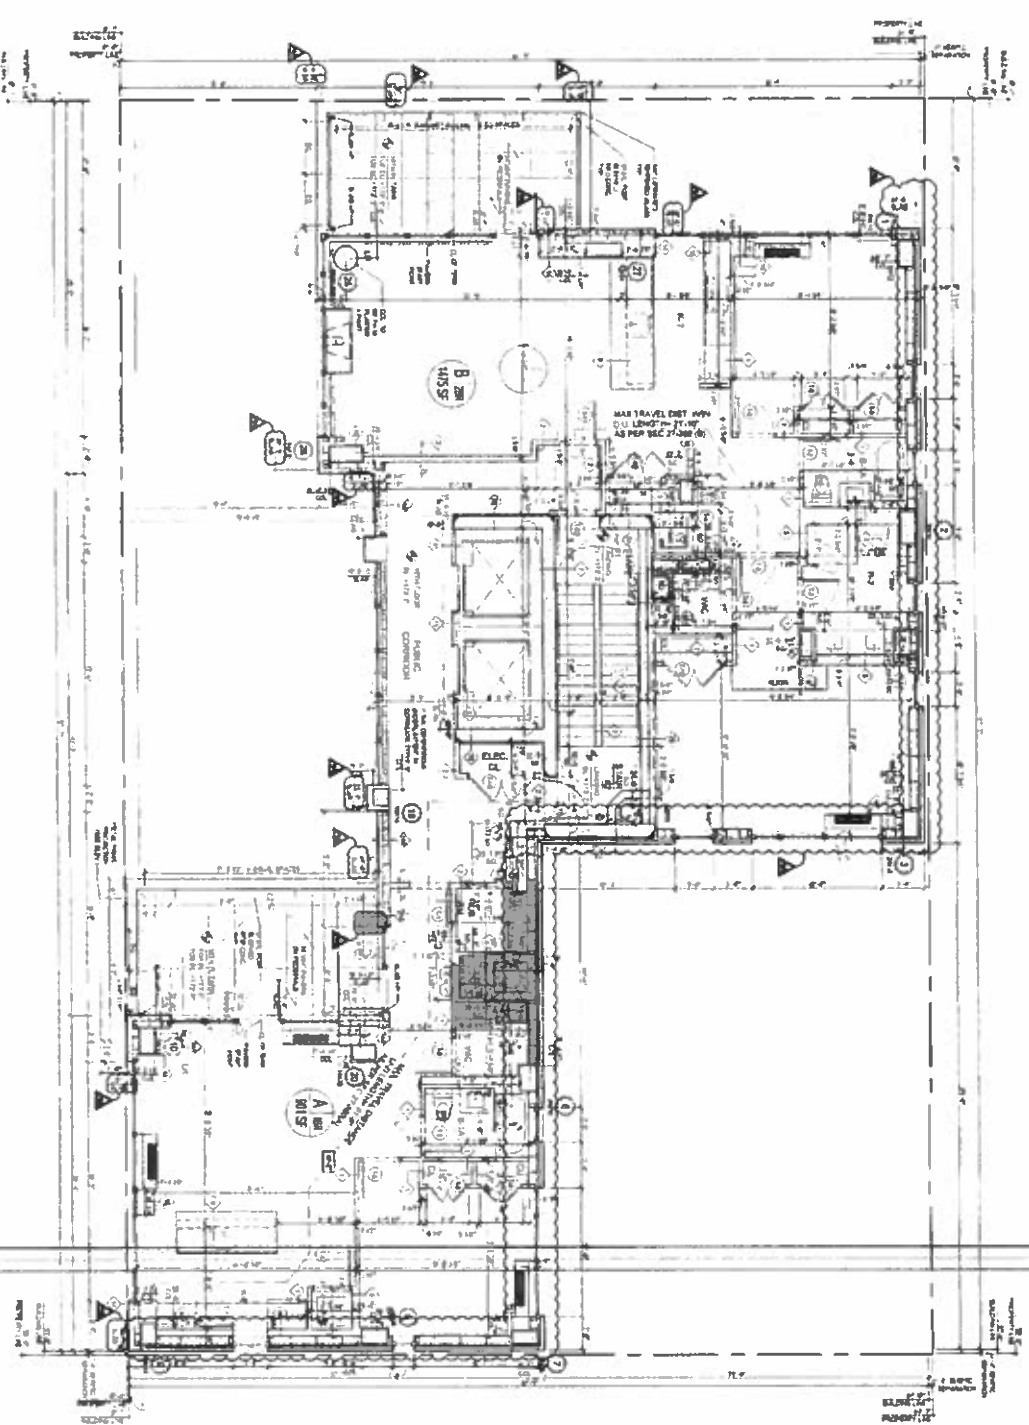

1 EIGHTEENTH FLOOR PLAN  
SCALE 1/4" = 1'-0"

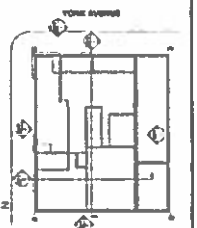

KEY PLAN

NOT TO SCALE  
FOR INFORMATION ONLY  
THIS PLAN IS NOT TO BE USED FOR CONSTRUCTION

021512	DOOR FRAME
071614	VALVE ENGINEERING REVISION #1A
040714	VALVE ENGINEERING REVISION #1
150410	RFM CONSTRUCTION
102713	ADDITIONAL #1
021512	DATA P.A.A.
041010	DATA REVISION #1
020412	DOOR SET

The Stephen B. Jacobs Group, P.C.  
Architects and Planners  
41 West Avenue South  
New York, NY 10018  
Tel: 212 312 1111

Andi Popper Interior Design  
Interior Design Firm  
333 East Avenue South  
New York, NY 10018  
Tel: 212 312 1111

W.S.P. Cantor Senick  
Consulting Engineers (Professional Registered)  
333 East Avenue South  
New York, NY 10018  
Tel: 212 312 1111


Sideris Kefalas Engineers  
Consulting Engineers (Professional Registered)  
217 E. 22nd Street, 10th Floor  
New York, NY 10010  
Tel: 212 312 1111

501 EAST 74TH STREET  
New York, NY 10018


18TH FLOOR CONSTRUCTION PLAN  
18TH FLOOR MARKETING PLAN

A-150.02



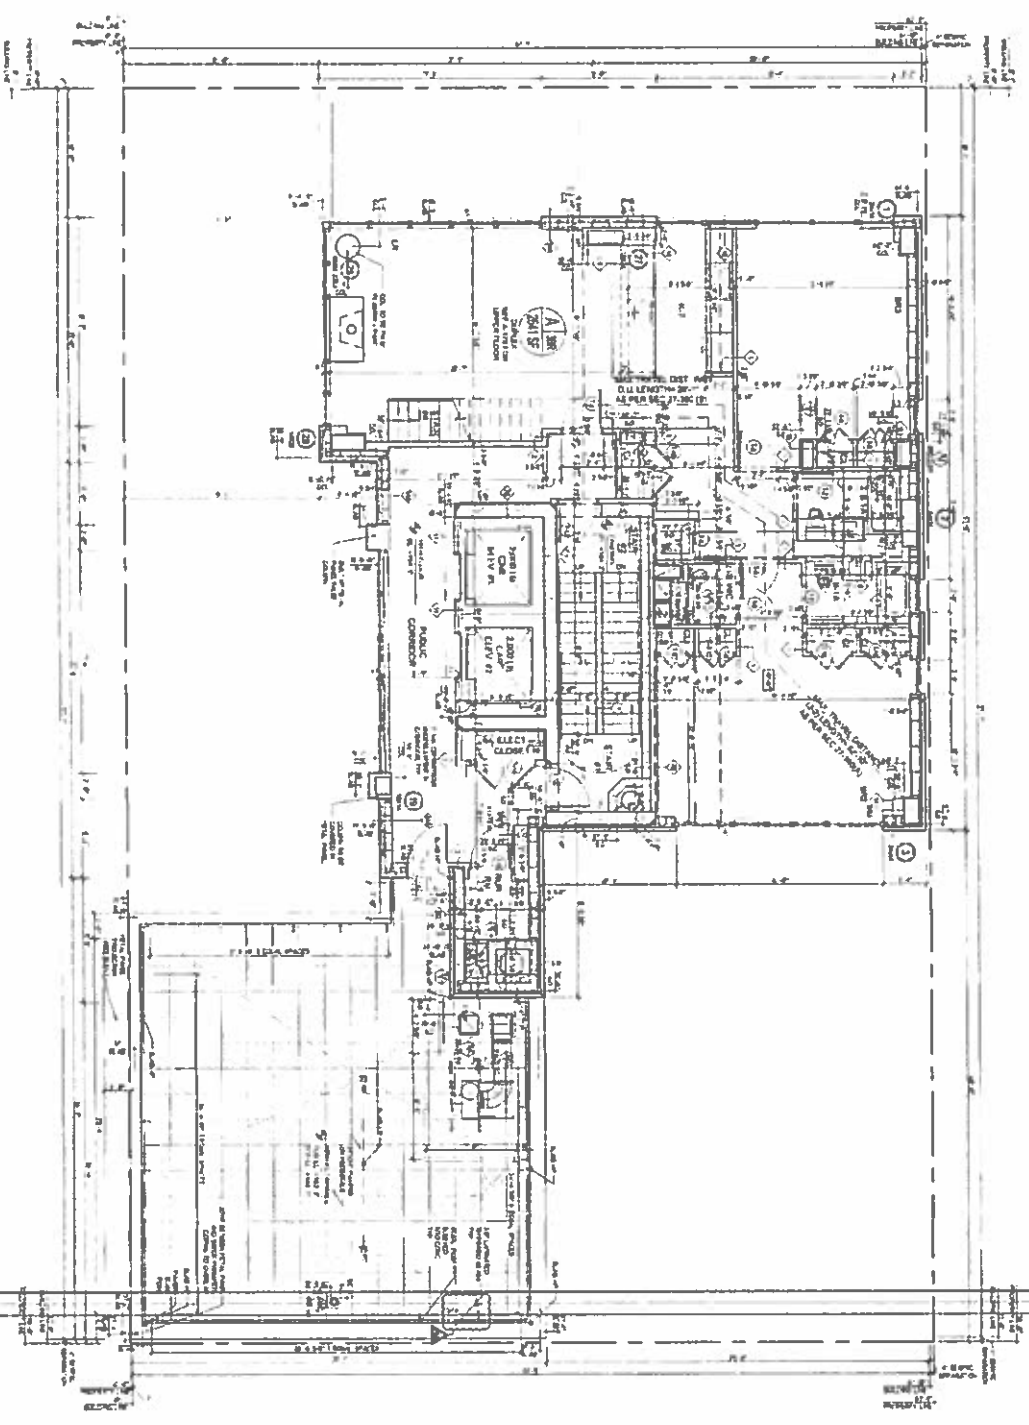

1 NINETEENTH FLOOR PLAN  
SCALE 1/8" = 1'-0"

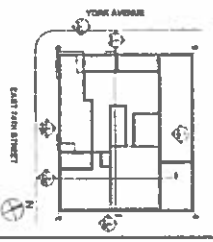

KEY PLAN  
EAST 74TH STREET  
YORK AVENUE

607315	D.O.B. PLANS
151614	POST APPROVAL AMENDMENT 01
070114	VAL LE ENGINEERING REVIEW 01A
042714	VAL LE ENGINEERING REVIEW 01
151615	AS-BUILT CONSTRUCTION
151616	AS-BUILT 01
070115	D.O.B. P.A.A. 1
070116	DOB EST

**The Stephen B. Jacobs Group, P.C.**  
Architects and Planners  
411 Park Avenue South  
New York, N.Y. 10018  
Phone: 212-771-7111  
Fax: 212-771-7112


**Audi Pepper Interior Design**  
Interior Designers  
441 Park Avenue South  
New York, N.Y. 10018  
Phone: 212-471-7112  
Fax: 212-471-7112


**W.S.P. Cadlor Schenk**  
Engineering Engineers (Professional Engineering)  
212 East 42nd Street  
New York, N.Y. 10017  
Phone: 212-485-4000  
Fax: 212-485-4000

**Sidaris Kefalas Engineers**  
Consulting Engineers (Civil & Structural)  
212 East 42nd Street  
New York, N.Y. 10017  
Phone: 212-278-0001  
Fax: 212-278-0001


501 EAST 74TH STREET  
New York, N.Y. 10018

REGISTERED ARCHITECT  
**STEPHEN B. JACOBS**  
ARCHITECT  
151614  
A-160.02

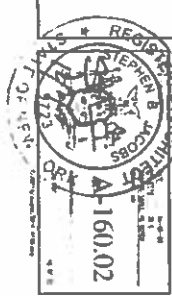

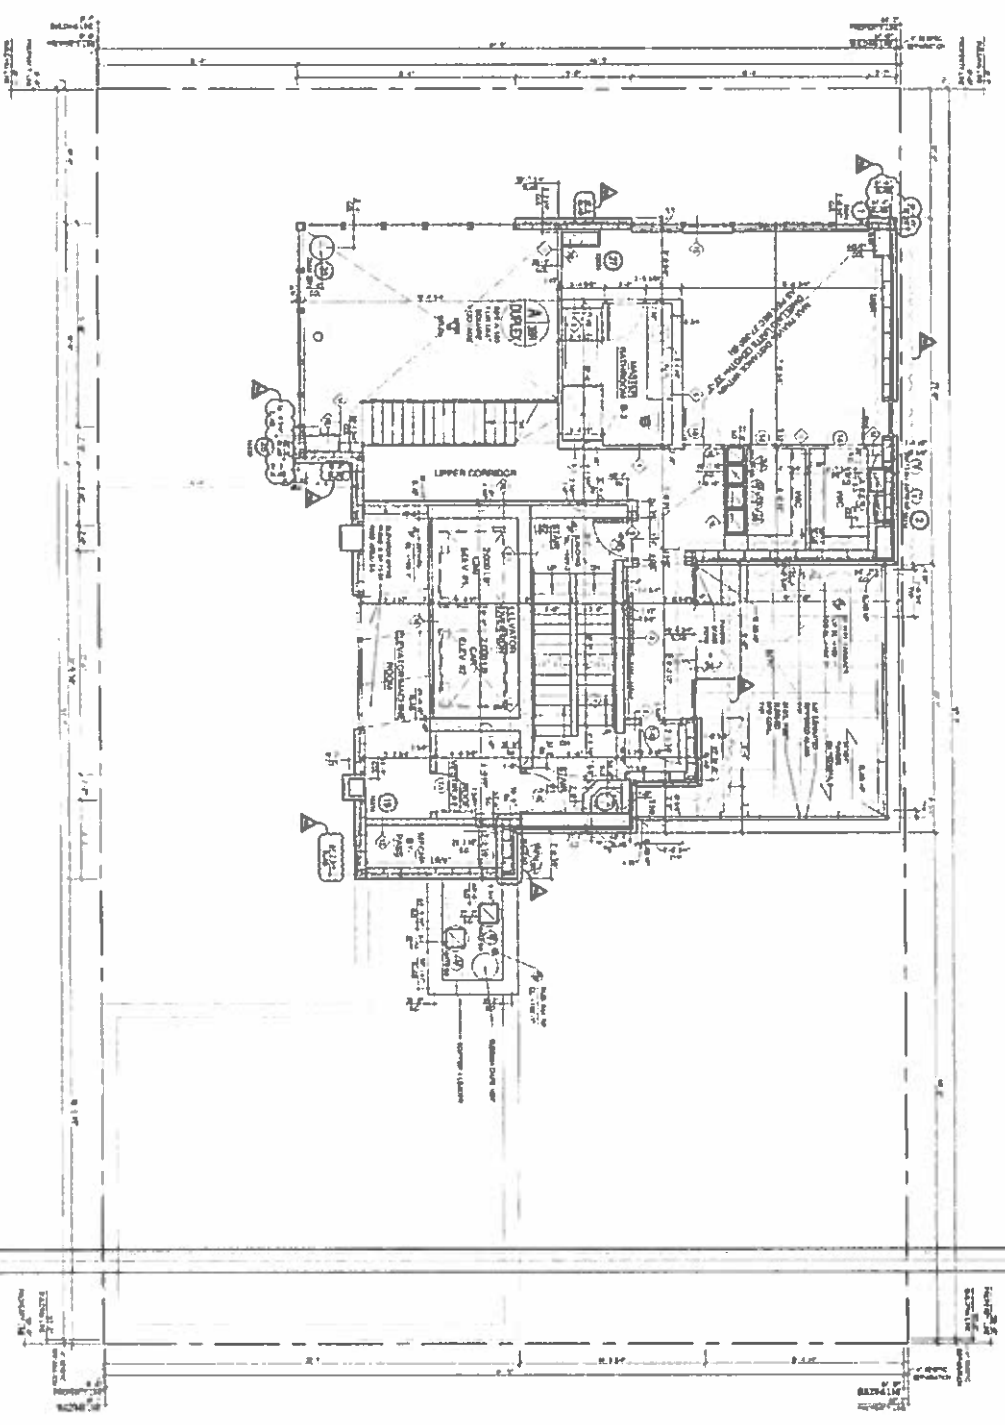

1 TWENTIETH FLOOR PLAN  
SCALE: 1/8" = 1'-0"

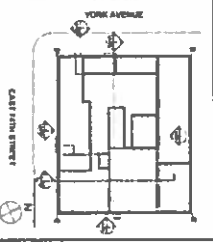

KEY PLAN

NOT TO SCALE  
FOR INFORMATION ONLY  
SEE ARCHITECTURAL RECORDS FOR ALL DIMENSIONS

001910	DOB P.A.L.B.
001914	VAL OF PROFESSIONAL SERVICES IN A
002714	VALUE ENGINEERING SERVICES IN
114015	NON CONSTRUCTION
100215	ASSEMBLY R
000611	DOB P.A.L.B.
000615	DOB P.A.L.B.
000617	DOB P.A.L.B.

The Stephen B. Jacobs Group, P.C.  
Architects and Interiors  
307 Park Avenue South  
New York, NY 10010  
212.465.1112

Audi Popper Interior Design  
307 Park Avenue South  
New York, NY 10010  
212.465.1112

W.S.P. Caulor Schuk  
Consulting Engineers (Professional Engineers)  
225 East 43rd Street  
New York, NY 10017  
212.467.4888

Sideris Kafalis Engineers  
Consulting Engineers (Professional Engineers)  
110 West 42nd Street  
New York, NY 10018  
212.467.4888


501 EAST 74TH STREET  
New York, NY 10018

20TH FLOOR CONSTRUCTION PLAN  
21ST FLOOR MARKETING PLAN

A.170.01






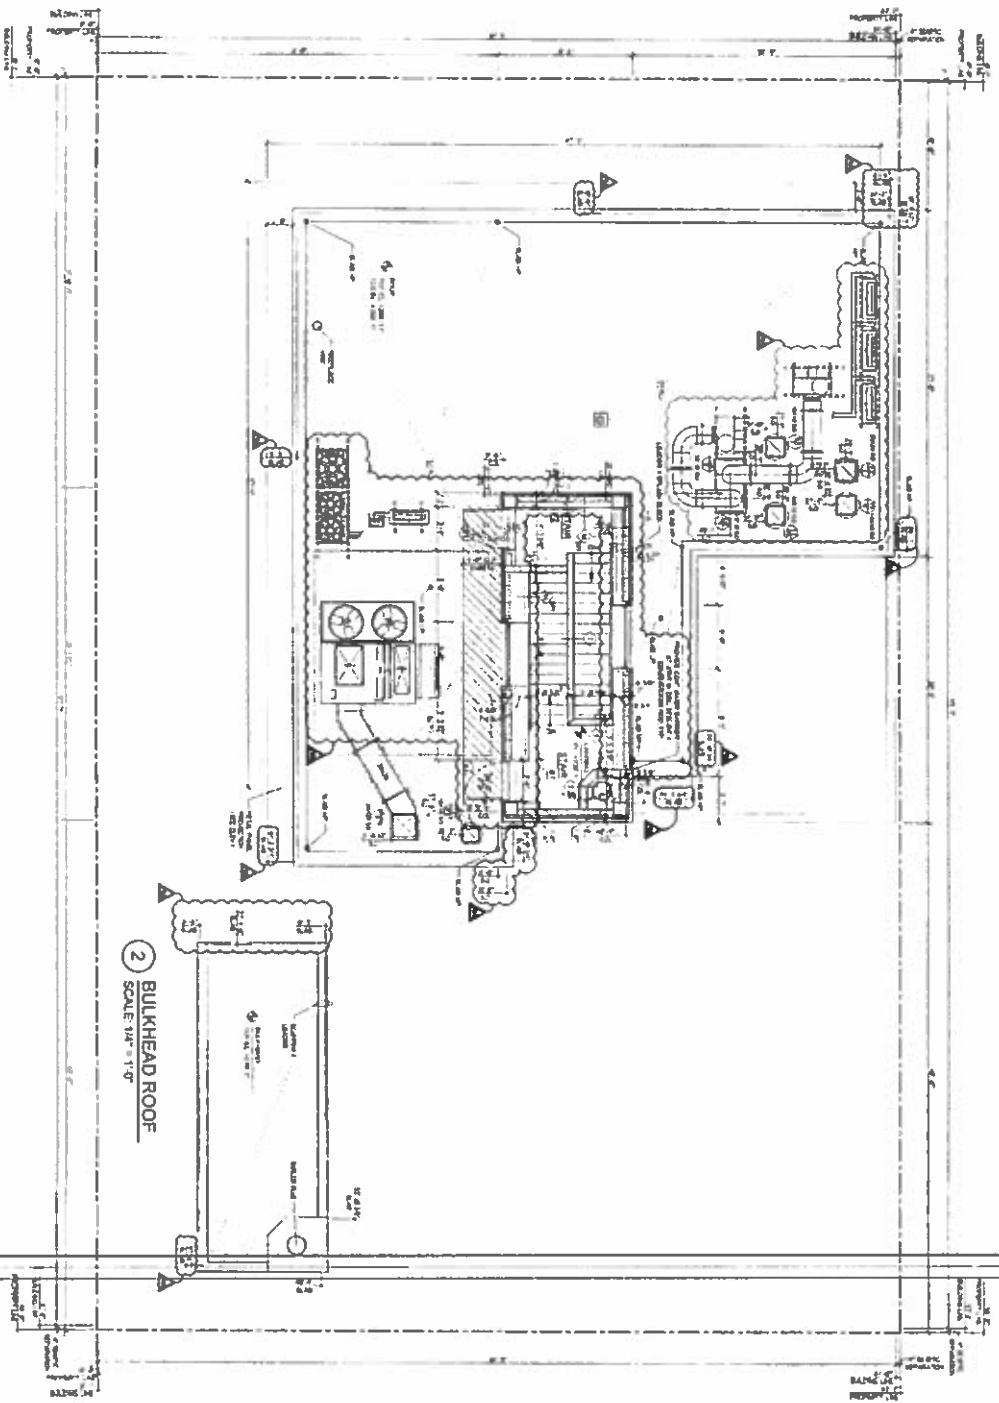

1 ROOF PLAN  
SCALE 1/4" = 1'-0"

2 BULKHEAD ROOF  
SCALE 1/4" = 1'-0"

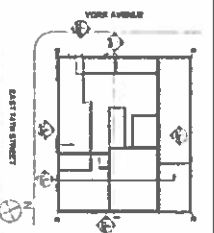

KEY PLAN

NOT TO SCALE  
FOR INFORMATION ONLY  
SEE ARCHITECTURAL RECORDS FOR FULL SET OF PLANS

DATE	DATE	DATE	DATE
1/1/00	1/1/00	1/1/00	1/1/00
1/1/00	1/1/00	1/1/00	1/1/00
1/1/00	1/1/00	1/1/00	1/1/00

**The Stephen B. Jacobs Group, P.C.**  
 301 Park Avenue  
 New York, N.Y. 10017  
 212-687-1212

**Andi Pepper Interior Design**  
 Interior Design  
 200 West 11th Street  
 New York, N.Y. 10011  
 212-411-0112

**W.S.P. Cantor Smith**  
 Consulting Engineers (Professional Engineering)  
 228 Park Avenue  
 New York, N.Y. 10017  
 212-687-0999

**Sideris Kefalas Engineers**  
 Consulting Engineers (Professional Engineering)  
 112-27 Madison Avenue  
 New York, N.Y. 10017  
 212-251-0001

**501 EAST 74TH STREET**  
 New York, N.Y. 10018

**MAIN ROOF, STAIR BULKHEAD  
 AND BULKHEAD ROOF PLANS**

